


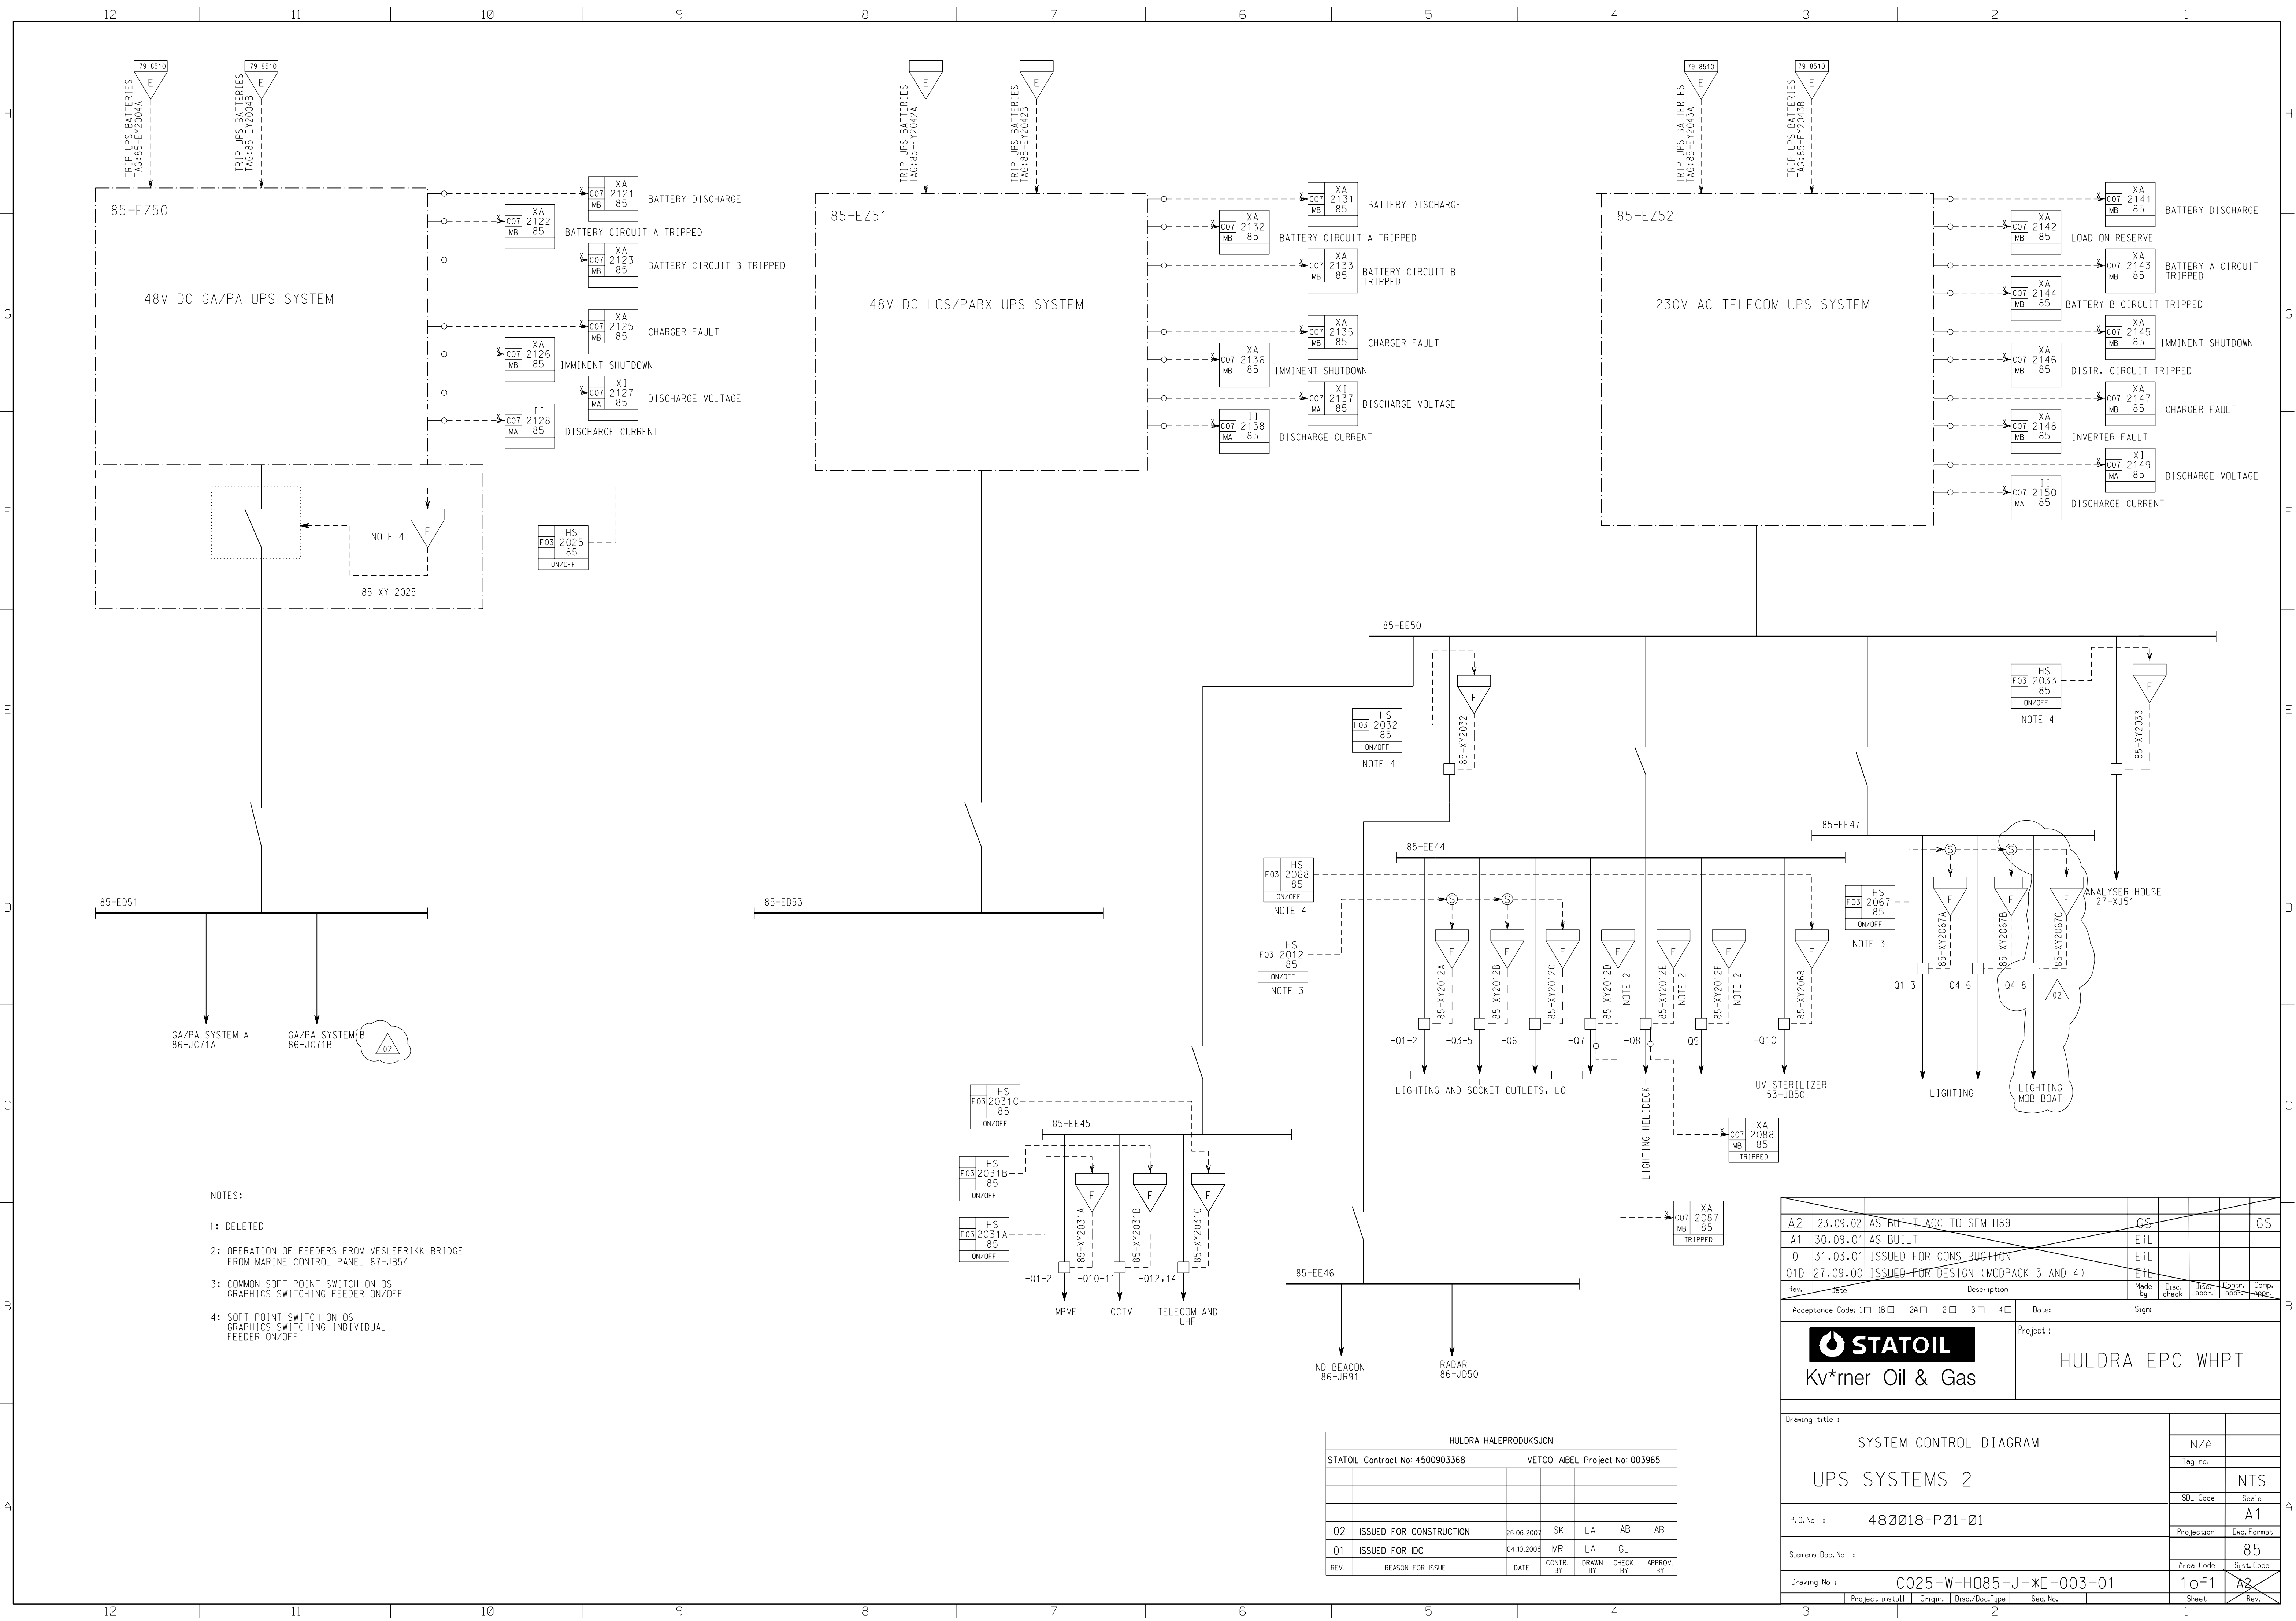

A2	23.09.02	AS BUILT ACC TO SEM H89	GS			GS
A1	30.09.01	AS BUILT	EIL			
0	31.03.01	ISSUED FOR CONSTRUCTION	EIL			
01D	27.09.00	ISSUED FOR DESIGN (MODPACK 3 AND 4)	EIL			
Rev.	Date	Description	Made by	Disc. check	Disc. apprv.	Contr. apprv.
Acceptance Codes: ☐ 1B ☐ 2A ☐ 2 ☐ 3 ☐ 4 ☐			Sign:			
 Kv*mer Oil & Gas			Project:			
			HULDRA EPC WHPT			
Drawing title:						
SYSTEM CONTROL DIAGRAM			N/A			
			Tag no.			
UPS SYSTEMS 2					NTS	
			SOL Code		Scale	
P.O.No : 480018-P01-01					A1	
Siemens Doc. No :			Projection		Dwg. Format	
					85	
Drawing No : C025-W-H085-J-*E-003-01			Area Code		Syst. Code	
					1 of 1	
Project install		Origin.	Disc./Doc. Type	Seq. No.	Sheet	Rev.

HULDRA HALEPRODUKSJON						
STATOIL Contract No: 4500903368			VETCO ABEL Project No: 003965			
02	ISSUED FOR CONSTRUCTION	26.06.2007	SK	LA	AB	AB
01	ISSUED FOR IDC	04.10.2006	MR	LA	CL	
REV.	REASON FOR ISSUE	DATE	CONTR. BY	DRAWN BY	CHECK BY	APPROV. BY