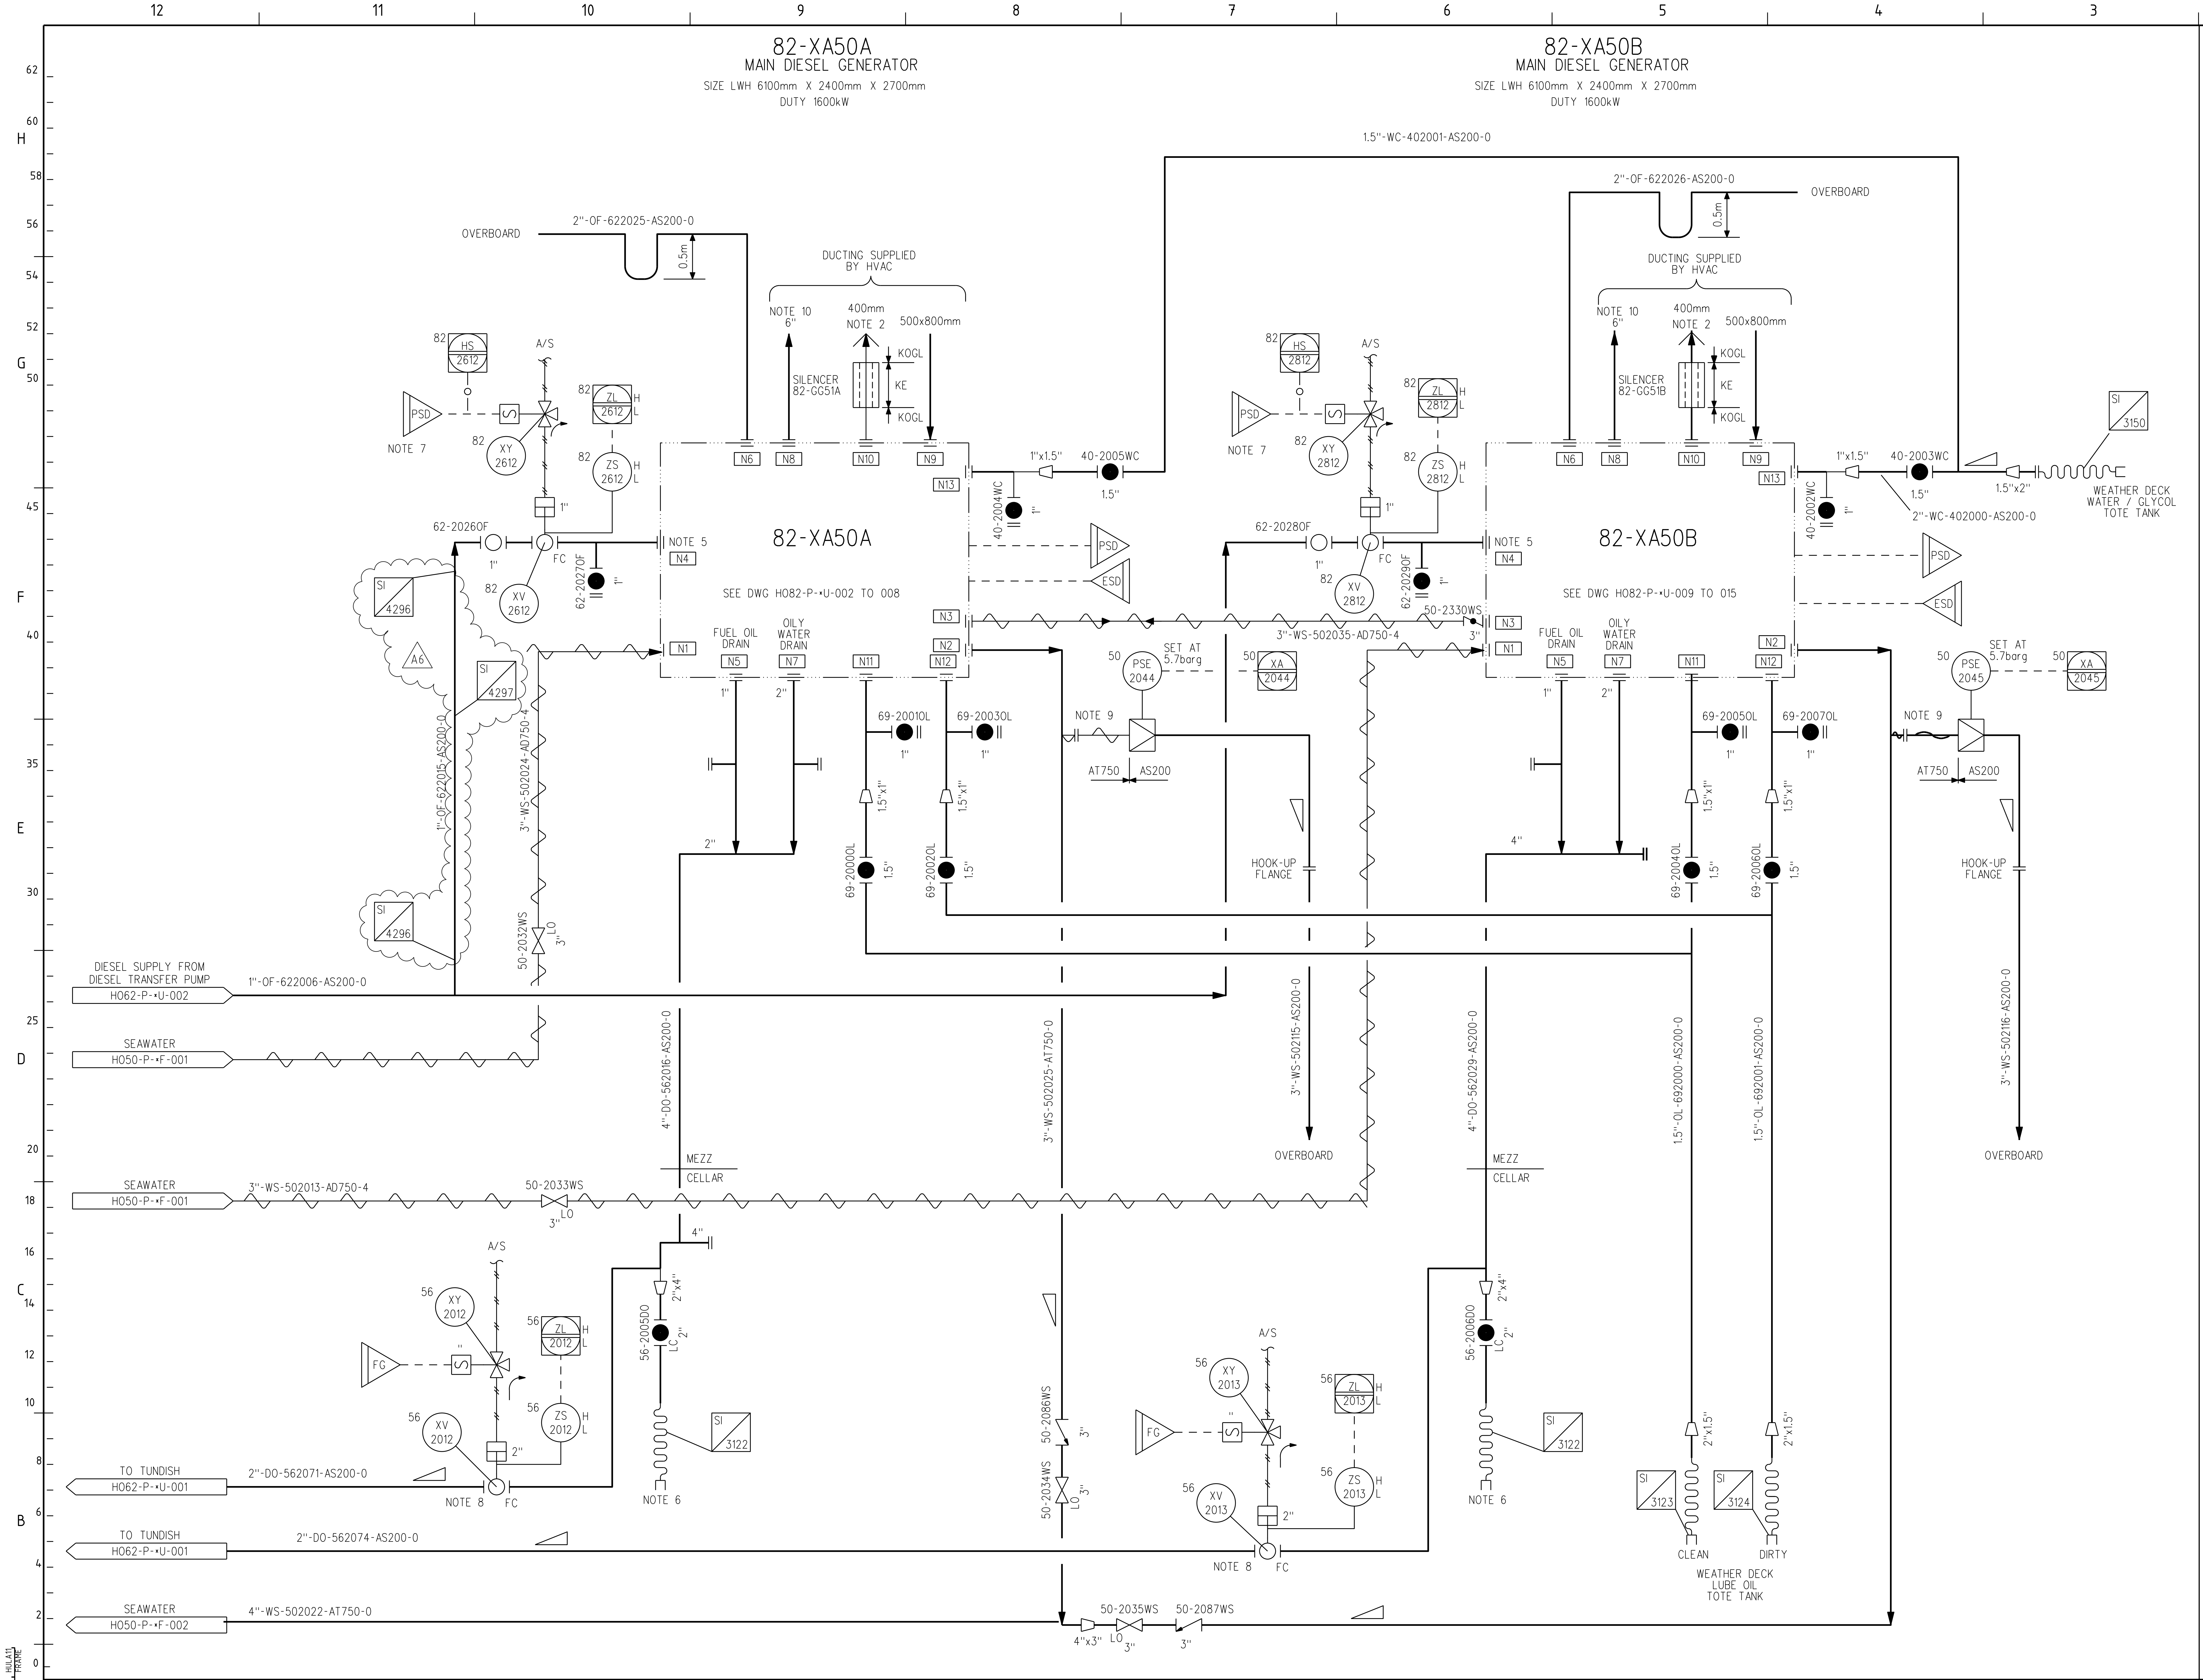

NOTES

1. DELETED.
2. EXHAUST VENT (& SILENCER) TO BE GUARDED FOR PERSONNEL PROTECTION. TERMINATION FLARE BOOM.
3. DELETED.
4. DELETED.
5. ON/OFF VALVE TO BE USED TO SHUT OFF IN FLOW TO DIESEL DAY TANK. HIGH LEVEL IN DAY TANK TO TRIP XV.
6. TO BARREL OR TOTE TANK ON CELLAR DECK.
7. SIGNAL COMES FROM INSIDE GENERATOR PACKAGE.
8. THESE TWO VALVES ARE NORMALLY OPEN, CLOSE ON F&G DETECTION OR AIR FAILURE. THEY NEED A SOFTWARE COMMAND WHICH CLOSES THEM WHEN BULK OIL DRAINAGE IS BEING DONE TO THE TOTE TANK.
9. BURSTING DISC INLET TO BE AS SHORT AS PRACTICAL WITH AS FEW FITTINGS AS POSSIBLE.
10. HVAC EXHAUST.

DRG. NO.	REFERENCE DRAWINGS	REV.	REASON FOR ISSUE	DATE	DRN.	CHK.	DISC. SUP.	DDB
		A6	AS BUILT WBS T.0051C.GA.11001/WO 22709592	04.12.14	LS	KM	MH	
		A5	AS BUILT A0600134/ SWO 80	30.09.03	NH-J	PAT	RT	DB
		A4	AS BUILT SWO 63	07.01.03	NH-J	STÅ	RT	SN
		A3	AS BUILT	25.02.02	NH-J	BH	BH	PJD
		A2	AS BUILT	12.09.01	REH	PJD	PJD	PJD

REV.	REASON FOR ISSUE	DATE	DRN.	CHK.	DISC. SUP.	DDB
A1	AS BUILT	03.09.01	REH	PJD	PJD	PJD
0C	ISSUED FOR COMMISSIONING INC RN 19	23.03.01	WB	DLA	RAS	KJF
0B	ISSUED FOR COMMISSIONING INC RN 16-18	20.11.00	WB	JG	JG	JG
0A	AFC INC RN 12 - 15	08.08.00	WB	RGK	JG	RGG
0	AFC INC RN 9 - 11	30.03.00	RGK	MZW	JG	PB

SYSTEM NO: 82

WORK PACK NO:

STATOIL

Kværner Oil & Gas
KVÆRNER™

SCALE: N.T.S.

PROJECTION:

Huldra EPC WHPT

TITLE:
PIPING AND INSTRUMENT DIAGRAM
DIESEL POWER GENERATORS

DRAWING NO.: C025-W-H082-P-×U-001-01

REV. A6

PROJECT NO. | CONTR. | AREA/SYS | DISC. | TYPE | NUMBER | SHT.NO | REV.

Statoil UBT - MicroStation - A1
PEGS REF 1311 PROJ 010 AREA 020 DOC 8201 SHEET 0B ISSUE HULA11 FRAME