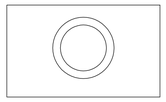

COM001
COMPONENTS
MAN WAY

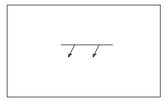

COM002
COMPONENTS
WASHING SYSTEM

COM003
COMPONENTS
INTERNAL SPRAY NOZZLE

COM004
COMPONENTS
ELECTRICAL HEATING COOLER

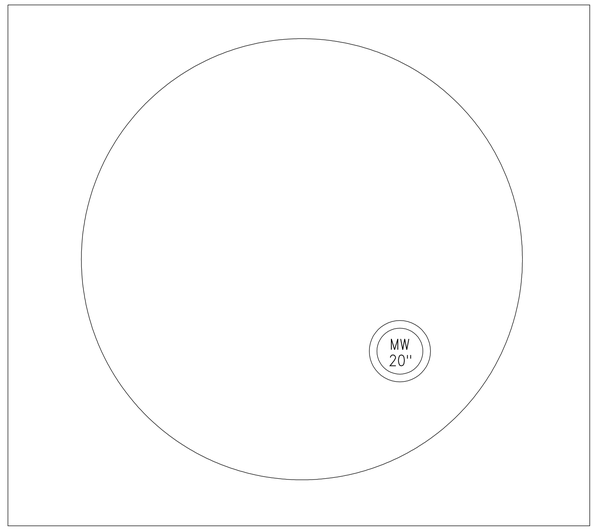

COM011
COMPONENTS
HIGH PRESSURE SEPARATOR

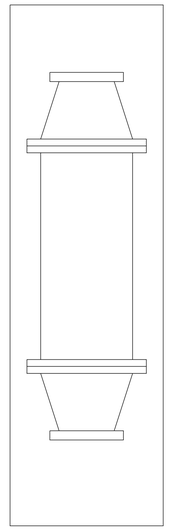

COM012
COMPONENTS
CRUDE HEATER

COM005
COMPONENTS
VANE DEMISTER

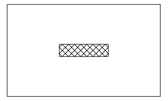

COM006
COMPONENTS
WIRE MESH DEMISTER

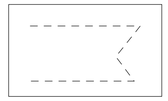

COM007
COMPONENTS
INTERNAL COIL1

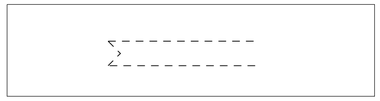

COM008
COMPONENTS
INTERNAL COIL2

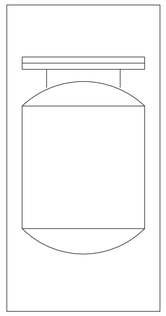

COM013
COMPONENTS
P-UNIT

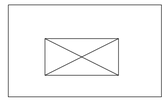

COM009
COMPONENTS
VORTEX BREAKER

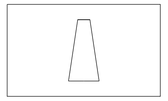

COM014
COMPONENTS
VENT OR FLARETIP

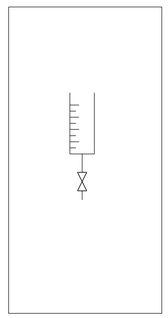

COM015
COMPONENTS
CALIBRATION VESSEL

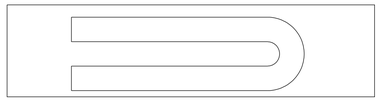

COM010
COMPONENTS
DOUBLE PIPE EXCHANGER

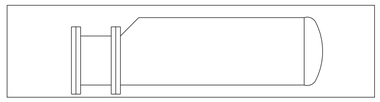

COM016
COMPONENTS
KETTLE REBOILER

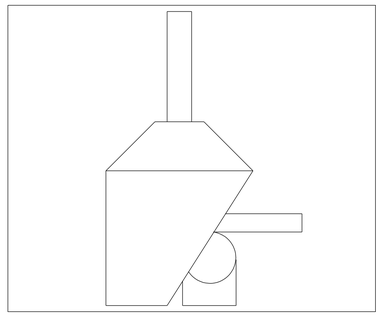

COM018
COMPONENTS
CENTRIFUGAL SEPARATOR

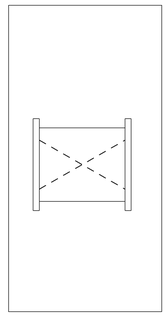

COM019
COMPONENTS
PLATE EXCHANGER

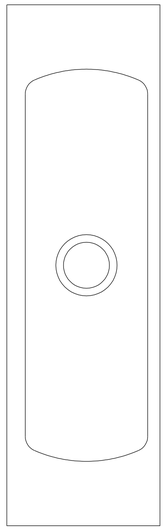

COM024
COMPONENTS
STCELL

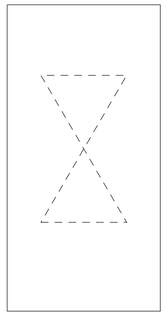

COM020
COMPONENTS
TOWER PACKING

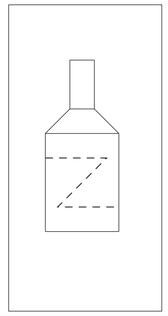

COM021
COMPONENTS
FIRED HEATER

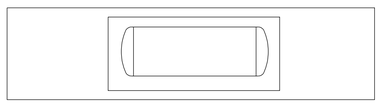

COM017
COMPONENTS
TOTE TANK

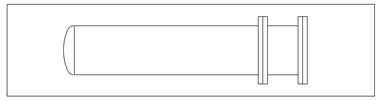

COM022
COMPONENTS
HEAT, SHELL & TUBE EXCH.

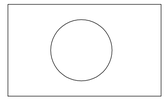

COM023
COMPONENTS
COMMINUTOR

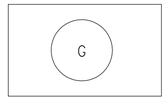

COM030
COMPONENTS
GENERATOR

COM025
COMPONENTS
CHIMNEY TRAY

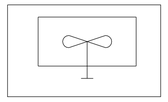

COM026
COMPONENTS
FORC. DRAFT AIR COOL. EXCH.

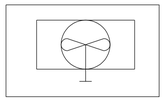

COM027
COMPONENTS
IND. DRAFT AIR COOL. EXCH

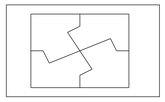

COM028
COMPONENTS
COMPACT HEAT EXCH.

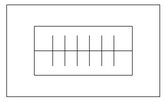

COM029
COMPONENTS
FIN EXCHANGER

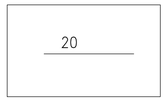

COM031
COMPONENTS
TOWER TRAY WITH NUMBER

NOTE:
REPLACES OLD DRAWINGS:
C001-A-000-PT-501-01
C001-A-000-PT-502-01
C008-A-000-PT-104-01
C008-A-000-PT-106-01
C017-A-000-PT-501-01
C017-A-000-PT-502-01
C025-C-0000-PT-004-01
C025-D-0000-PT-004-01

REV.	REASON FOR ISSUE	DATE	DRN.	CHK.	DISC. SUP.	DDB
A3	AS BUILT ACC. TO M5: 40764203	07.04. 2008	TV	LM	EVDO	GUL
A2	AS BUILT ACC. TO M5: 40462960	29.08. 2005	ESK	MSH		GULL
A1	AS BUILT	15.11. 1999	MSH	KNS	MS	MS
0	ISSUED FOR CONSTRUCTION (REDRAWN)	22.04. 1999	MSH / KNS	KNS	SB	ES

DRG. NO.	REFERENCE DRAWINGS

SYSTEM NO.

WORK PACK NO.

STATOIL

GULLFAKS/VESLEFRIKK/HULDRA

TITLE:
COMPONENTS
DRAFTING STANDARD

SCALE:

PROJECTION:

DRAWING NO.: U999-1-000-PT-106- 01 A3

PROJECT NO.	CONTR.	AREA	DISC.	NUMBER	SHT.NO	REV.

Statoil DDB D.A.K.