NOTES:

1. VIA PROFIBUS DP FROM ELEKTRONICON.
2. CONTROL BLOCK FOR THE COMPRESSOR UNIT. CONTROL SIGNALS CORRESPONDING TO RUN, AVAIABLE FAULT ON PROFIBUS FROM ELEKTRONICON.

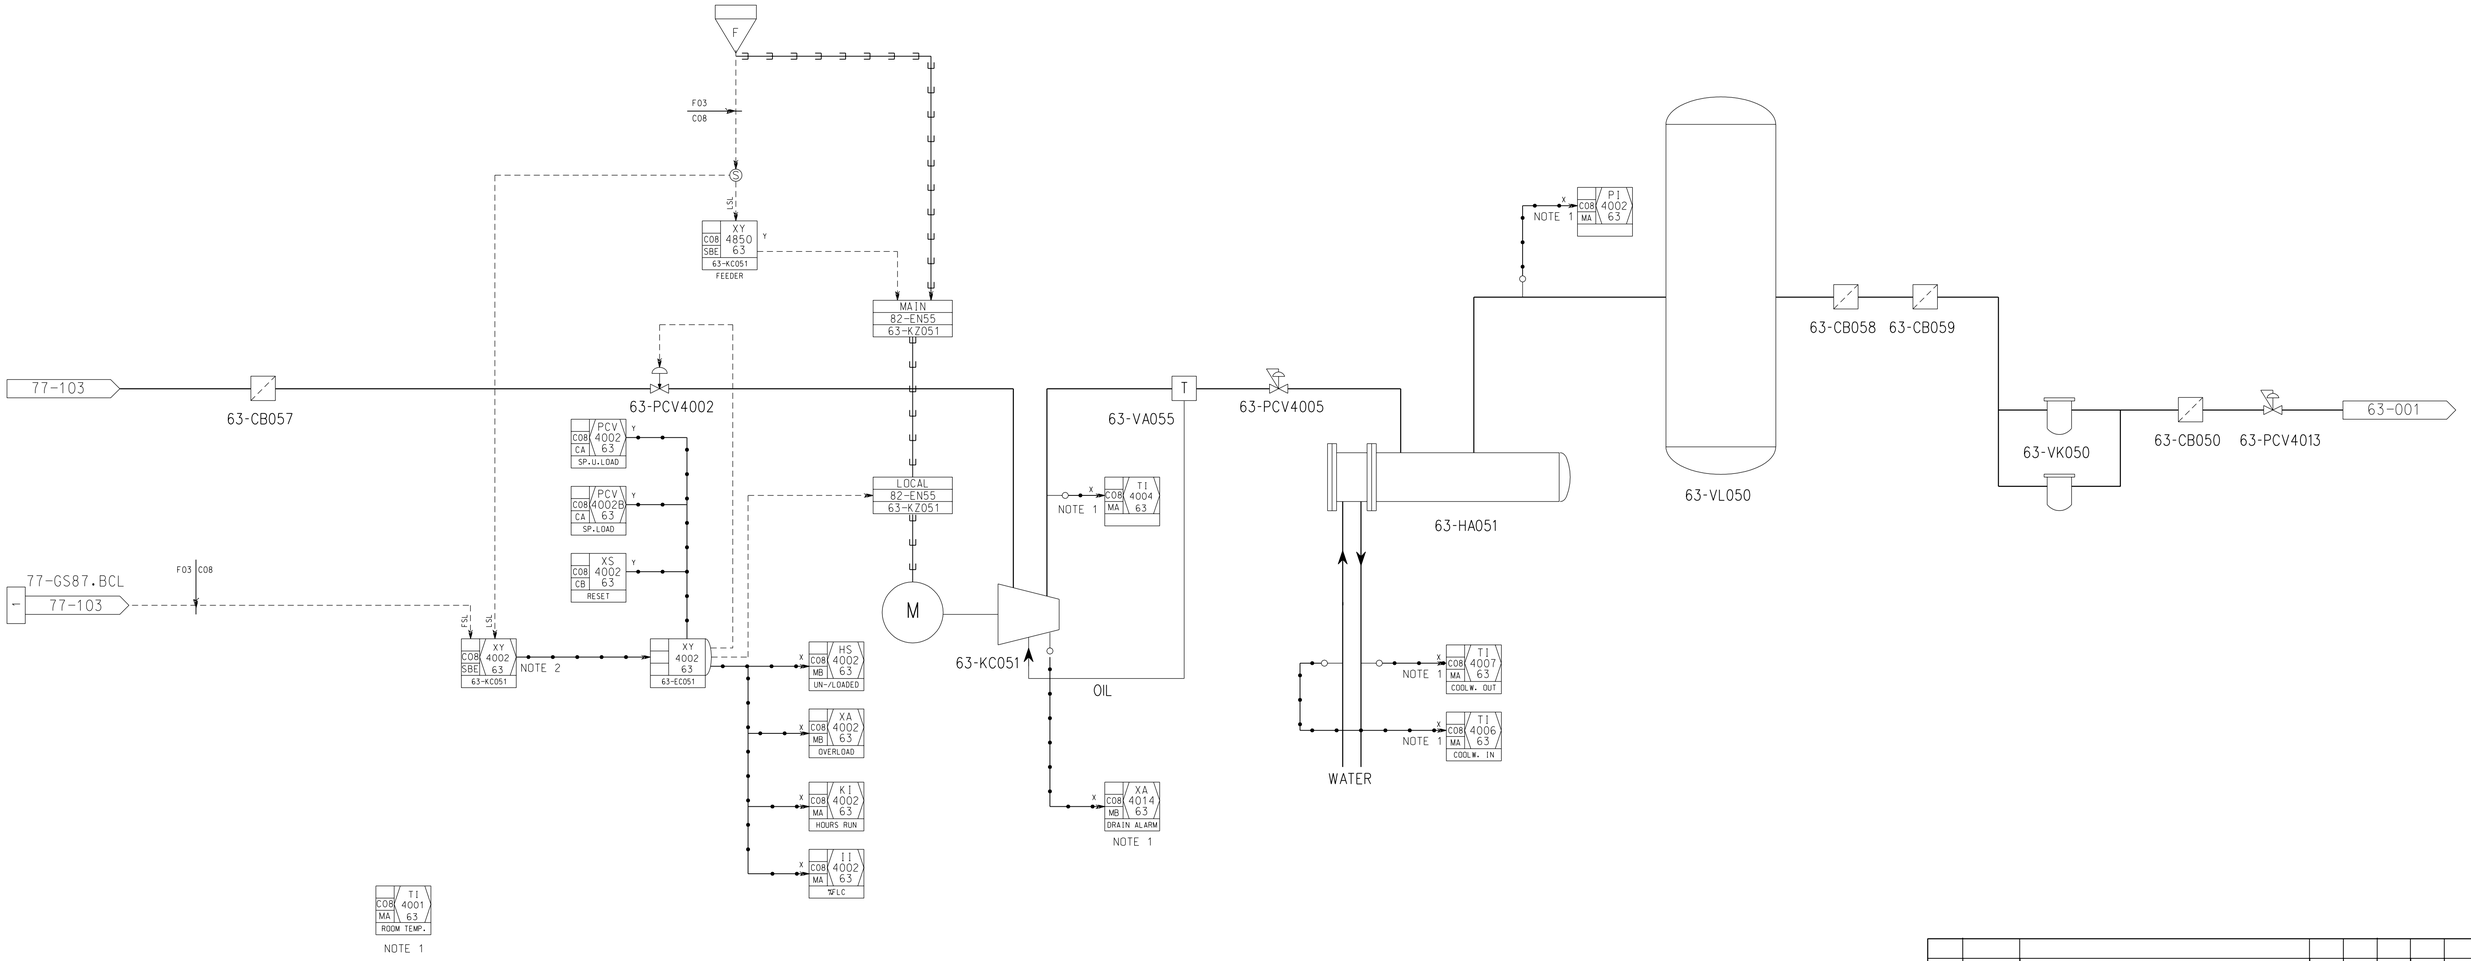


| Rev. | Date | Description | Made by | Disc. check | Disc. appr. | Contr. appr. | Comp. appr. |
|---|---|---|---|---|---|---|---|
| A1 | 29.08.2007 | AS BUILT, HHP-POJECT | MR | HB | AB | GS | |
| 03 | 22.12.2006 | REISSUED FOR CONSTRUCTION | MR | HB | AB | | |
| 02 | 01.08.2006 | ISSUED FOR CONSTRUCTION | JIO | TS | AS | AS | |
| 01 | 26.07.2006 | ISSUED FOR IDC | JIO | TS | AS | AS | |

Acceptance Code: 1☐ 1B☐ 2A☐ 2☐ 3☐ 4☐ Date: Signs

STATOIL vetco

Project: HULDRA HALEPRODUKSJON

Drawing title:

SYSTEM CONTROL DIAGRAM

AIR COMPRESSOR C

| | |
|---|---|
| N/A | |
| Tag no. | |
| | NTS |
| SDL Code | Scale |
| | A1 |
| Projecton | Dwg. Format |
| | 63 |
| Area Code | Syst. Code |
| 1of1 | A1 |
| Sheet | Rev. |

P.O.No :

Siemens Doc.No :

Drawing No : C025-V-H063-J-*E-101-01

Project install | Origin. | Disc./Doc.Type | Seq. No.