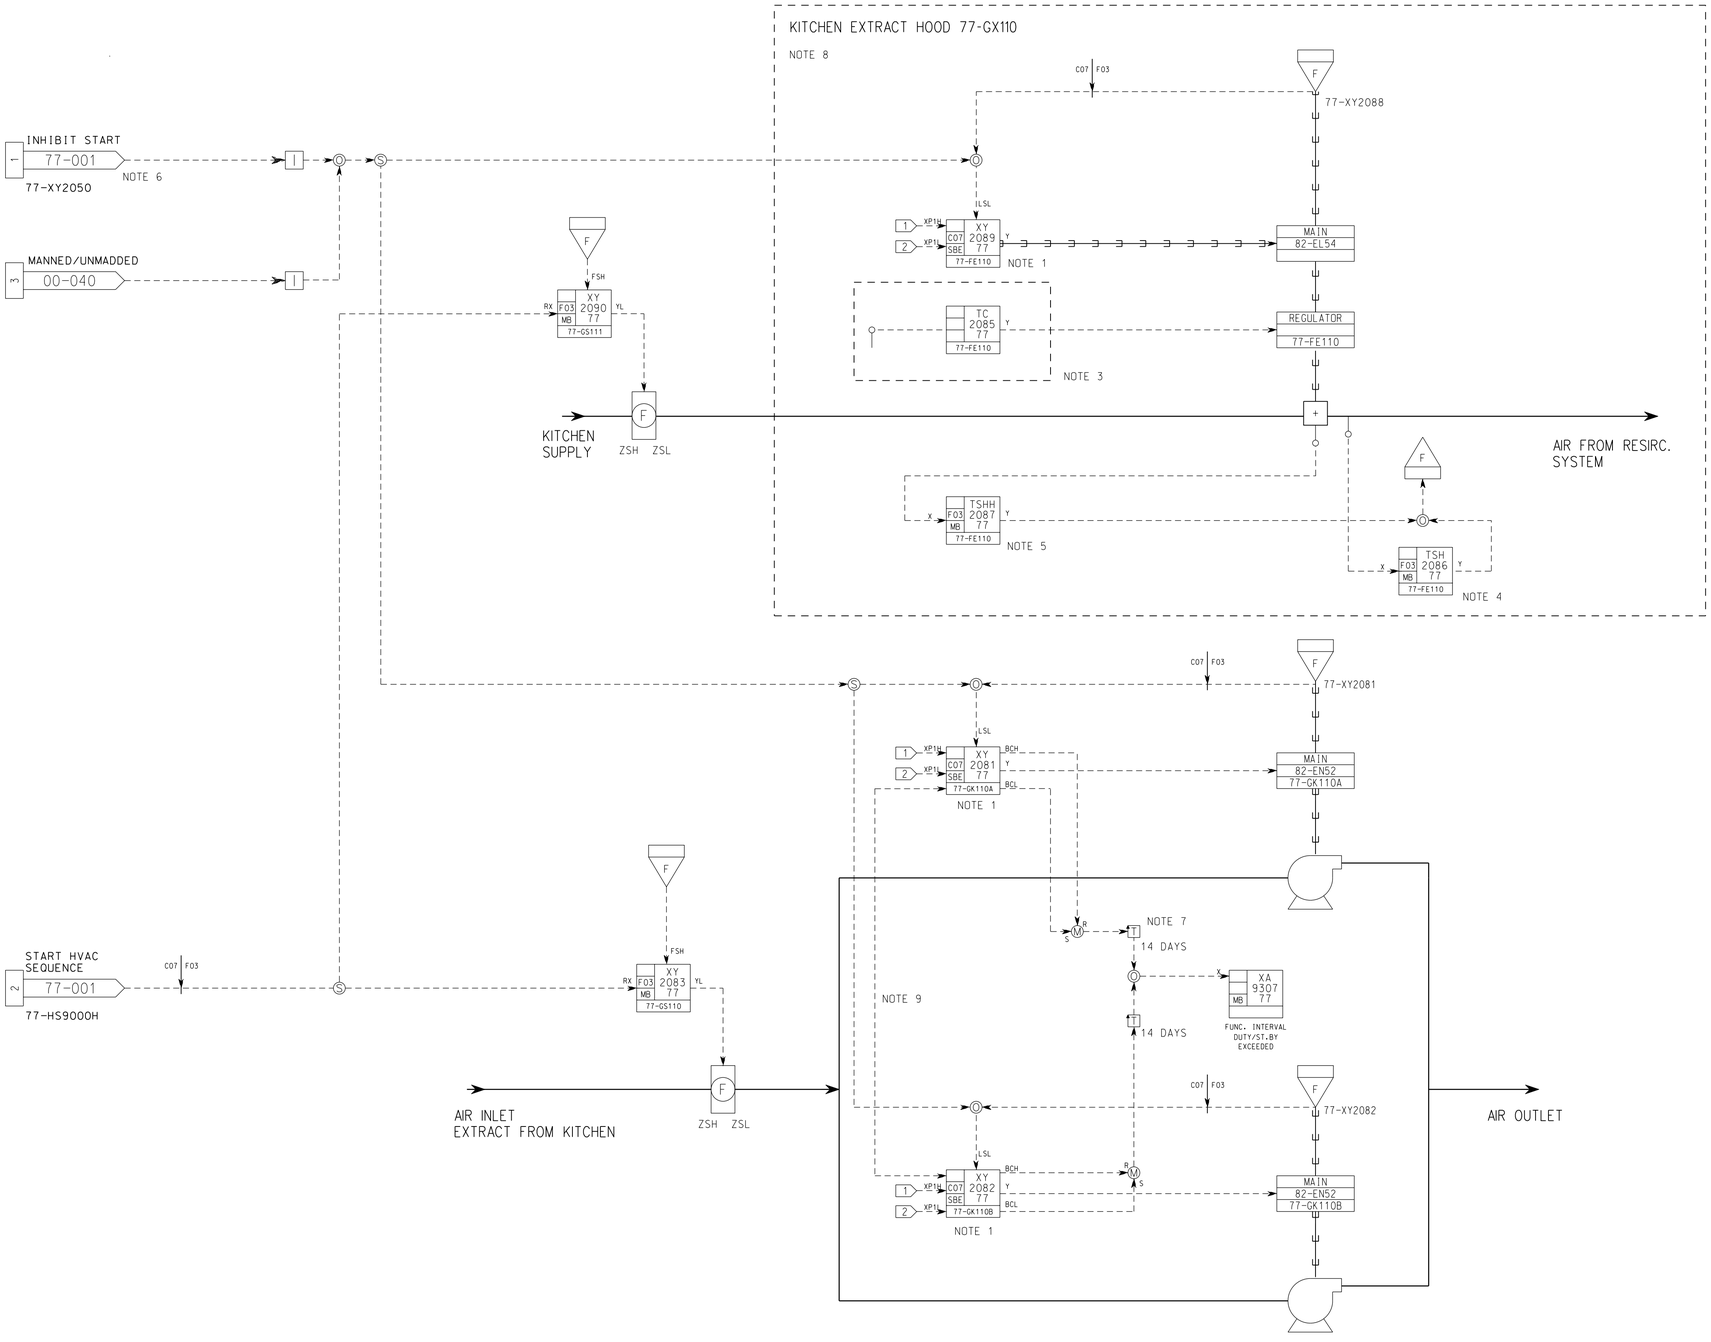


NOTES:

1. OBJECT CONTROLLER SHALL INCLUDE STATUS INFORMATION (E.G. FAULT, RUNNING, HOURS, CURRENT AND NUMBER OF STARTS).
2. SEQUENCE FAIL. LATCHED RESET FROM OS.
3. THERMOSTAT WITH BUILT IN ROOM SENSOR. SET POINT 22 DEG C
4. THERMOSTAT AIRSTREAM IN DUCT. AUTOMATIC RESET SET POINT 37 DEG C.
5. THERMOSTAT ELEMENT OVERHEATING. MANUAL RESET. SETPOINT 200 DEG C.
6. FANS AND HEATER ARE INHIBITED FROM RUNNING IF NOT HVAC SYSTEM IS RUNNING.
7. TIMERS START WHEN FANS STOP. WARNING ON OS IF NOT DUTY/STANDBY PRIORITY IS CHANGED WITHIN 14 DAYS.
8. HEATER IS A PART OF RESIRCULATION SYSTEM IN KITCHEN EXTRACT HOOD.
9. DUTY STANDBY CONNECTION.

GENERAL NOTE:

1 START GALLEY EXTRACT FAN SEQUENCE
2 STOP GALLEY EXTRACT FAN SEQUENCE

ALL SEQUENCES ARE DOCUMENTED IN DOC. C025-V-H077-J-*E-106-01

Rev.	Date	Description	Made by	Disc. check	Disc. appr.	Contr. appr.	Comp. appr.
A1	12.01.2010	AS BUILT ACC. TO AO. 20958634	KRPAS	EDARN	STTEI		VH

Acceptance Code: 1☐ 1B☐ 2A☐ 2☐ 3☐ 4☐ Date: Sign:

STATOIL vetco

Project: HULDRA HALEPRODUKSJON

Drawing title: SYSTEM CONTROL DIAGRAM
HVAC SYSTEM IN GALLEY

N/A	
Tag no.	
NTS	
SDL Code	Scale
A1	
Projection	Dwg.Format
77	
Area Code	Syst.Code
1of1	A1
Sheet	Rev.

P.O.No :
Siemens Doc.No :
Drawing No : C025-V-H077-J-*E-105-01

Project install | Origin. | Disc./Doc.Type | Seq.No.