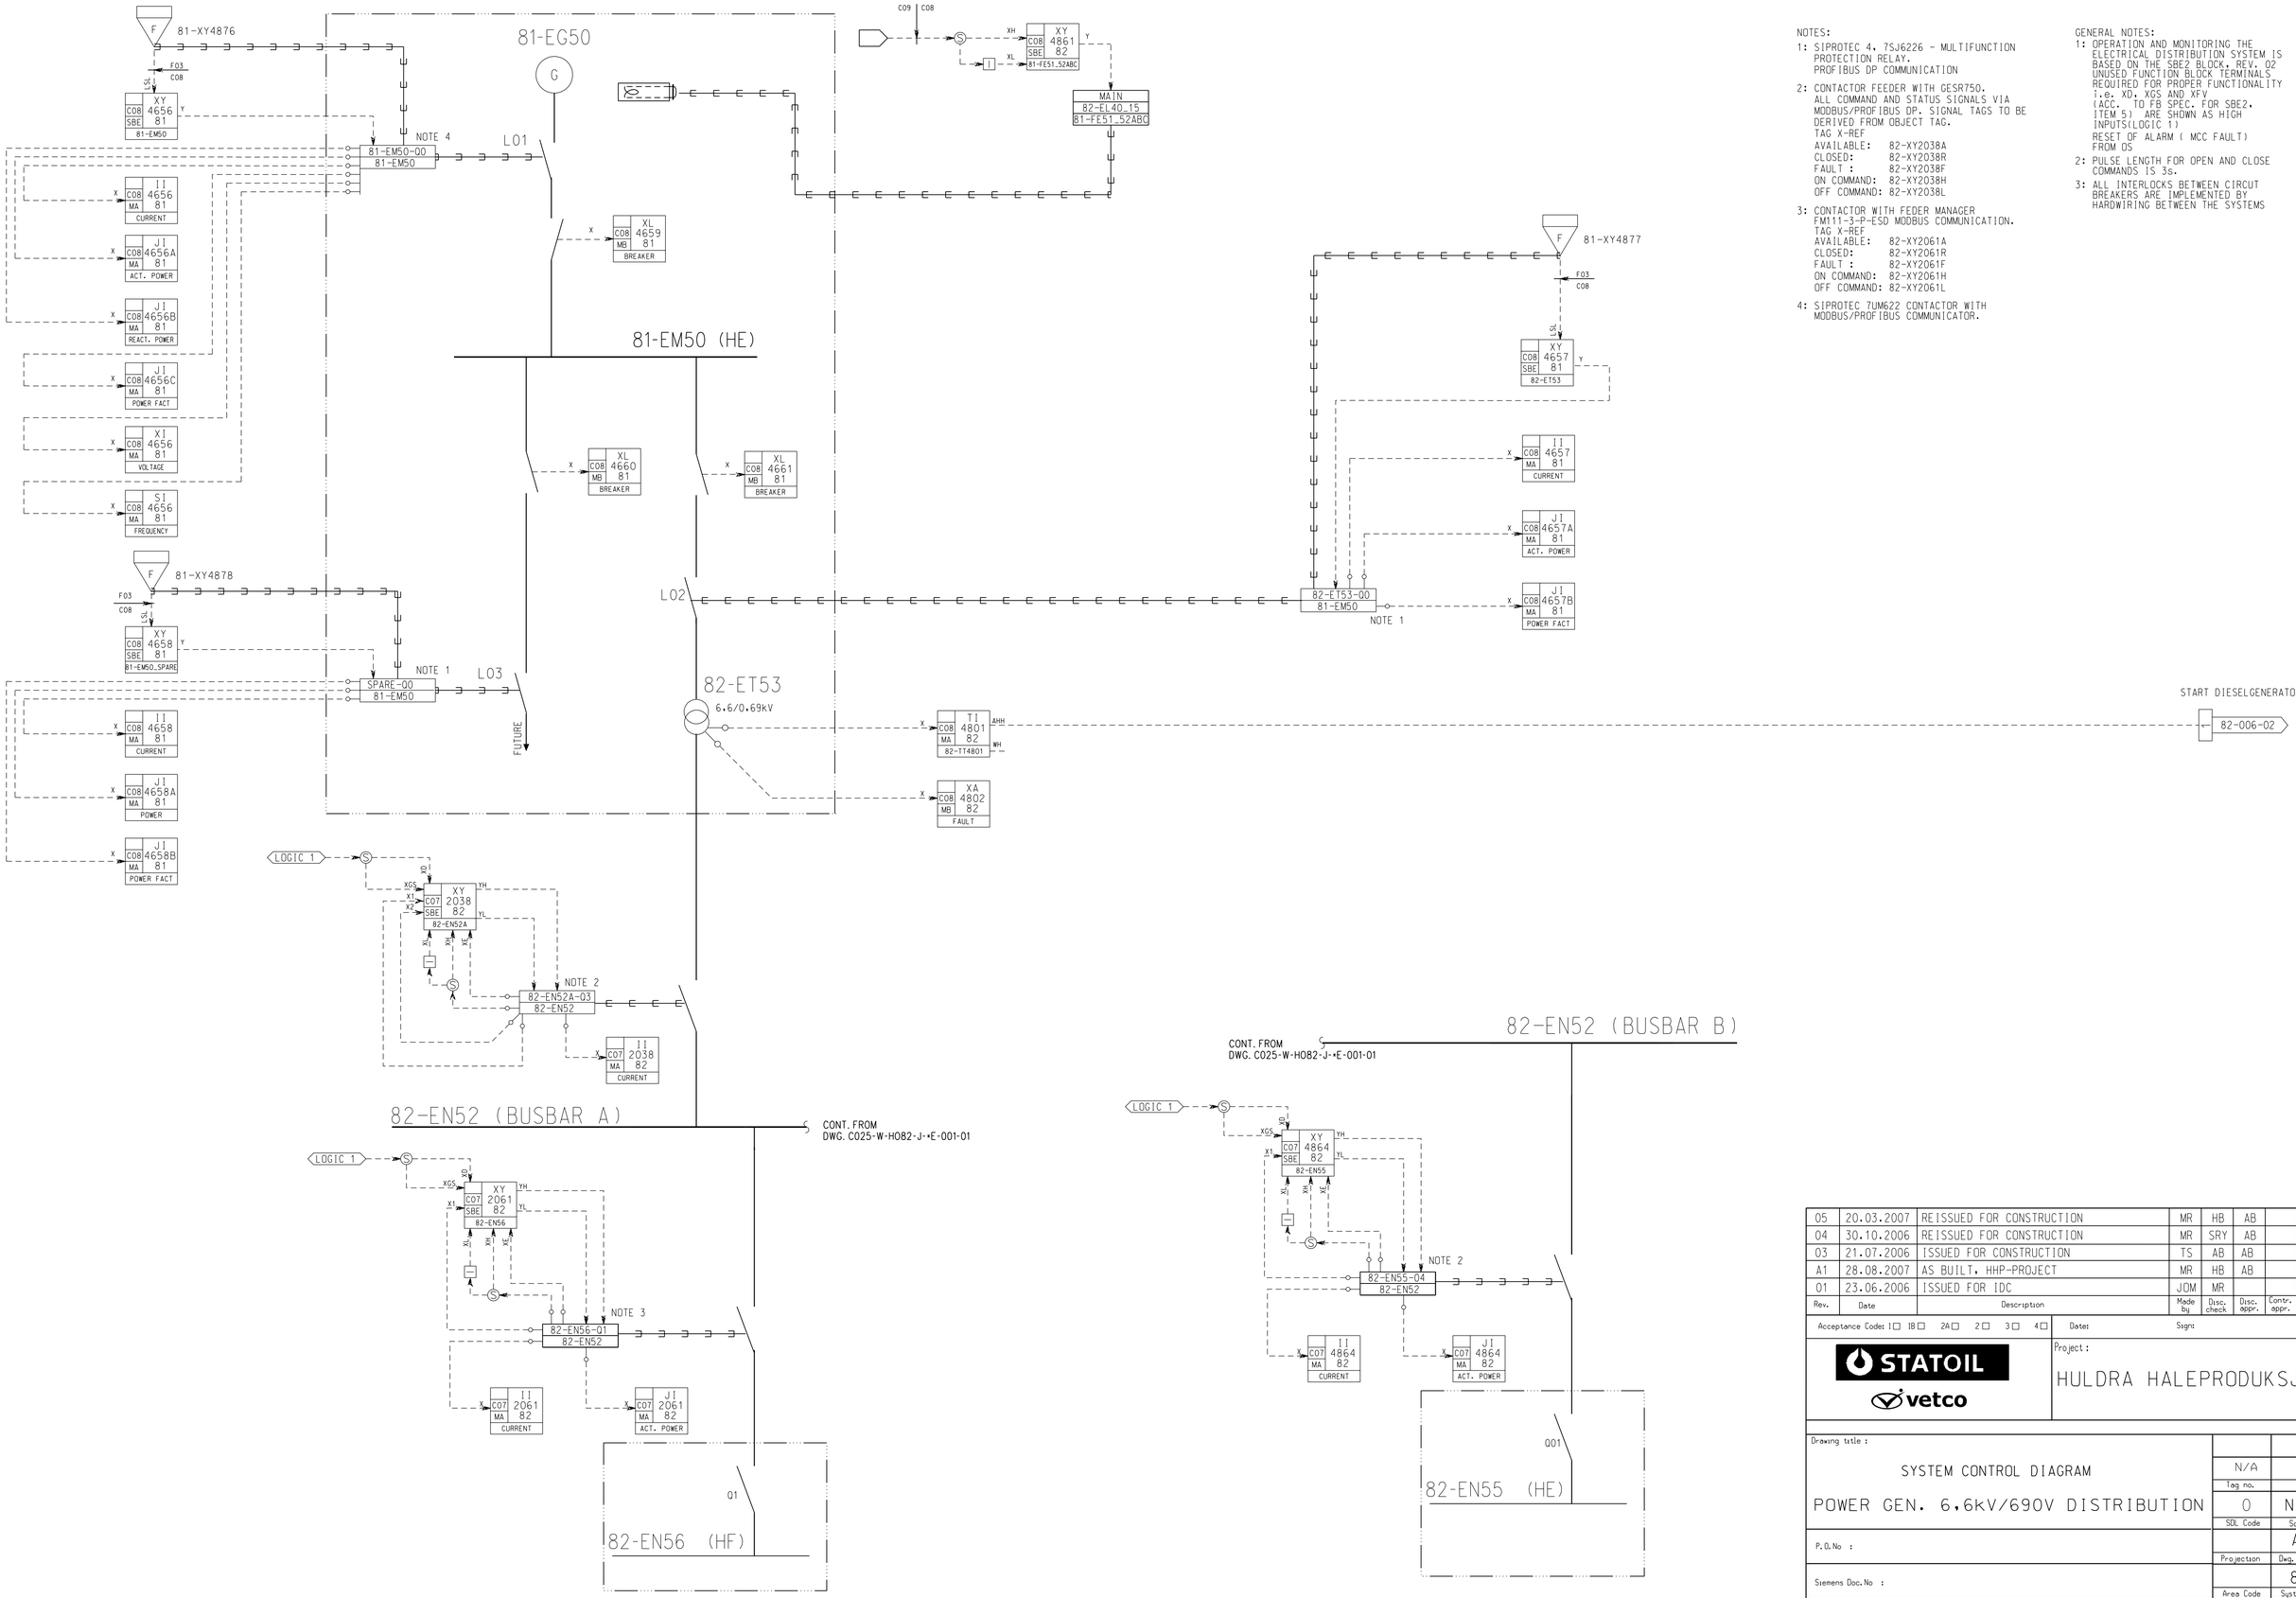

NOTES:

1: SIPROTEC 4. 7SJ6226 - MULTIFUNCTION PROTECTION RELAY.
PROFIBUS DP COMMUNICATION

2: CONTACTOR FEEDER WITH GESR750.
ALL COMMAND AND STATUS SIGNALS VIA MODBUS/PROFIBUS DP. SIGNAL TAGS TO BE DERIVED FROM OBJECT TAG.
TAG X-REF
AVAILABLE: 82-XY2038A
CLOSED: 82-XY2038R
FAULT : 82-XY2038F
ON COMMAND: 82-XY2038H
OFF COMMAND: 82-XY2038L

3: CONTACTOR WITH FEDER MANAGER FM111-3-P-ESD MODBUS COMMUNICATION.
TAG X-REF
AVAILABLE: 82-XY2061A
CLOSED: 82-XY2061R
FAULT : 82-XY2061F
ON COMMAND: 82-XY2061H
OFF COMMAND: 82-XY2061L

4: SIPROTEC 7UM622 CONTACTOR WITH MODBUS/PROFIBUS COMMUNICATOR.

GENERAL NOTES:

1: OPERATION AND MONITORING THE ELECTRICAL DISTRIBUTION SYSTEM IS BASED ON THE SBE2 BLOCK, REV. 02 UNUSED FUNCTION BLOCK TERMINALS REQUIRED FOR PROPER FUNCTIONALITY i.e. XD, XGS AND XFV (ACC. TO FB SPEC. FOR SBE2, ITEM 5) ARE SHOWN AS HIGH INPUTS(LOGIC 1)
RESET OF ALARM (MCC FAULT) FROM OS

2: PULSE LENGTH FOR OPEN AND CLOSE COMMANDS IS 3s.

3: ALL INTERLOCKS BETWEEN CIRCUT BREAKERS ARE IMPLEMENTED BY HARDWIRING BETWEEN THE SYSTEMS

Rev.	Date	Description	Made by	Disc. check	Disc. appr.	Contr. appr.	Comp. appr.
05	20.03.2007	REISSUED FOR CONSTRUCTION	MR	HB	AB		
04	30.10.2006	REISSUED FOR CONSTRUCTION	MR	SRY	AB		
03	21.07.2006	ISSUED FOR CONSTRUCTION	TS	AB	AB		
A1	28.08.2007	AS BUILT, HHP-PROJECT	MR	HB	AB		GS
01	23.06.2006	ISSUED FOR IDC	JOM	MR			

Acceptance Code: 1☐ 1B☐ 2A☐ 2☐ 3☐ 4☐ Date: Sign:

STATOIL
vetco

Project :
HULDRA HALEPRODUKSJON

Drawing title :
SYSTEM CONTROL DIAGRAM
POWER GEN. 6,6kV/690V DISTRIBUTION

N/A	
Tag no.	
0	NTS
SDL Code	Scale
	A1
Projection	Dwg. Format
	82
Area Code	Syst. Code
1of1	A1
Sheet	Rev.

P.O.No :

Siemens Doc.No :

Drawing No : C025-V-H082-J-*E-101-01

Project install | Origin. | Disc./Doc.Type | Seq.No.