TYPICAL CONFIGURATION OF CONTACTOR FEEDER WITH TRIP RELAY

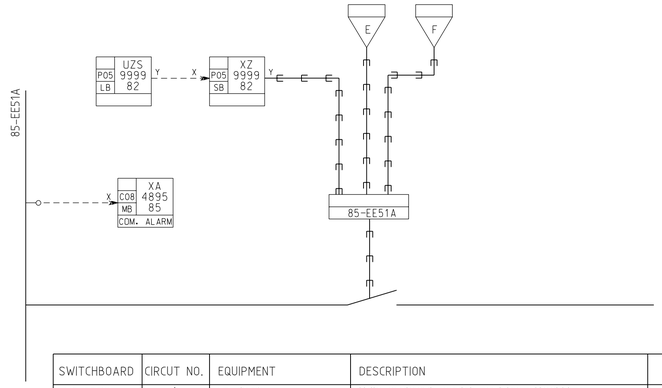

SWITCHBOARD	CIRCUT NO.	EQUIPMENT	DESCRIPTION	ESD TRIP	F&G TRIP	PSD TRIP
85-EE51A	1	27-JG50	UNIT CONTROL PANEL, POWER SUPPLY A			
85-EE51A	2	81-EC50	GENERATOR CONTROL PANEL, POWER SUPPLY A			
85-EE51A	3	82-EN55	690V MCC. POWER SUPPLY A			
85-EE51A	4	81-EM50	6,6 kV SWITCHBOARD, POWER SUPPLY A		85-XY4868A	
85-EE51A	5	45-JB051A	CALORIMETER POWER SUPPLY A			
85-EE51A	6	86-JC084	PATCH PANEL IN HER POWER SUPPLY		85-XY4870	
85-EE51A	7		SPARE			
85-EE51A	8	ES-EB-01_85-EE51A_08	SOCKETS OUTLET IN CER		85-XY4871A	
85-EE51A	9		SPARE			
85-EE51A	10		SPARE			
85-EE51A	11		SPARE			
85-EE51A	12		SPARE			
85-EE51A	13	87-JG56	PCS NODE, POWER SUPPLY A			
85-EE51A	14	50-FT4807	FLOW TRANSMITTER SEA WATER CIRCULATION			
85-EE51A	15	86-JC083	PATCH PANEL IN CER POWER SUPPLY A			

TYPICAL CONFIGURATION OF CONTACTOR FEEDER WITH TRIP RELAY

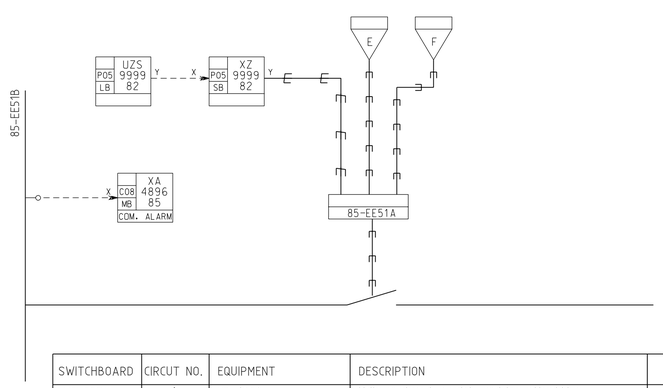

SWITCHBOARD	CIRCUT NO.	EQUIPMENT	DESCRIPTION	ESD TRIP	F&G TRIP	PSD TRIP
85-EE51B	1	27-JG50	UNIT CONTROL PANEL, POWER SUPPLY B			
85-EE55B	2	81-EC50	GENERATOR CONTROL PANEL, POWER SUPPLY B			
85-EE51B	3	82-EN55	690V MCC. POWER SUPPLY B			
85-EE51B	4	81-EM50	6,6 kV SWITCHBOARD, POWER SUPPLY B		85-XY4868B	
85-EE51B	5	45-JB051B	CALORIMETER POWER SUPPLY B			
85-EE51B	6		SPARE			
85-EE51B	7		SPARE			
85-EE51B	8	ES-EB-01_85-EE51B-08	SOCKET OUTLETS IN HER		85-XY4871B	
85-EE51B	9		SPARE			
85-EE51B	10		SPARE			
85-EE51B	11	EA-AD-01_85-EE51B_11	EMERGENCY LIGHTING COMPRESSOR MODULE CER			
85-EE51B	12	EA-AD-01_85-EE51B_12	EMERGENCY LIGHTING COMPRESSOR MODULE HER			
85-EE51B	13	87-JG56	PCS NODE, POWER SUPPLY B			
85-EE51B	14	86-JC083	PATCH PANEL IN CER, POWER SUPPLY B			
85-EE51B	15		SPARE			

Rev.	Date	Description	Made by	Disc. check	Disc. appr.	Contr. appr.	Comp. appr.
A1	28.08.2007	AS BUILT. HHP-PROJECT	AB	MR	AB		GS
04	21.02.2007	REISSUED FOR CONSTRUCTION	MR	SRY	AB		
03	30.10.2006	REISSUED FOR CONSTRUCTION	MR	SRY	AB		
02	25.07.2006	ISSUED FOR CONSTRUCTION	TS	AB	AB		
01	14.07.2006	ISSUED FOR IDC	TS	JOM	AB		

Acceptance Code: 1☐ 1B☐ 2A☐ 2☐ 3☐ 4☐ Date: Sign:

STATOIL
vetco

Project: HULDRA HALEPRODUKSJON

Drawing title:
SYSTEM CONTROL DIAGRAM
UPS FEEDERS
COMPRESSOR MODULE

N/A	Tag no.
0	NTS (SDL Code / Scale)
	A1 (Projection / Dwg. Format)
	82 (Area Code / Syst. Code)
1of1	A1 (Sheet / Rev.)

P.O.No :

Siemens Doc.No :

Drawing No : C025-V-H085-J-*E-101-01

Project install | Origin. | Disc./Doc.Type | Seq.No.