


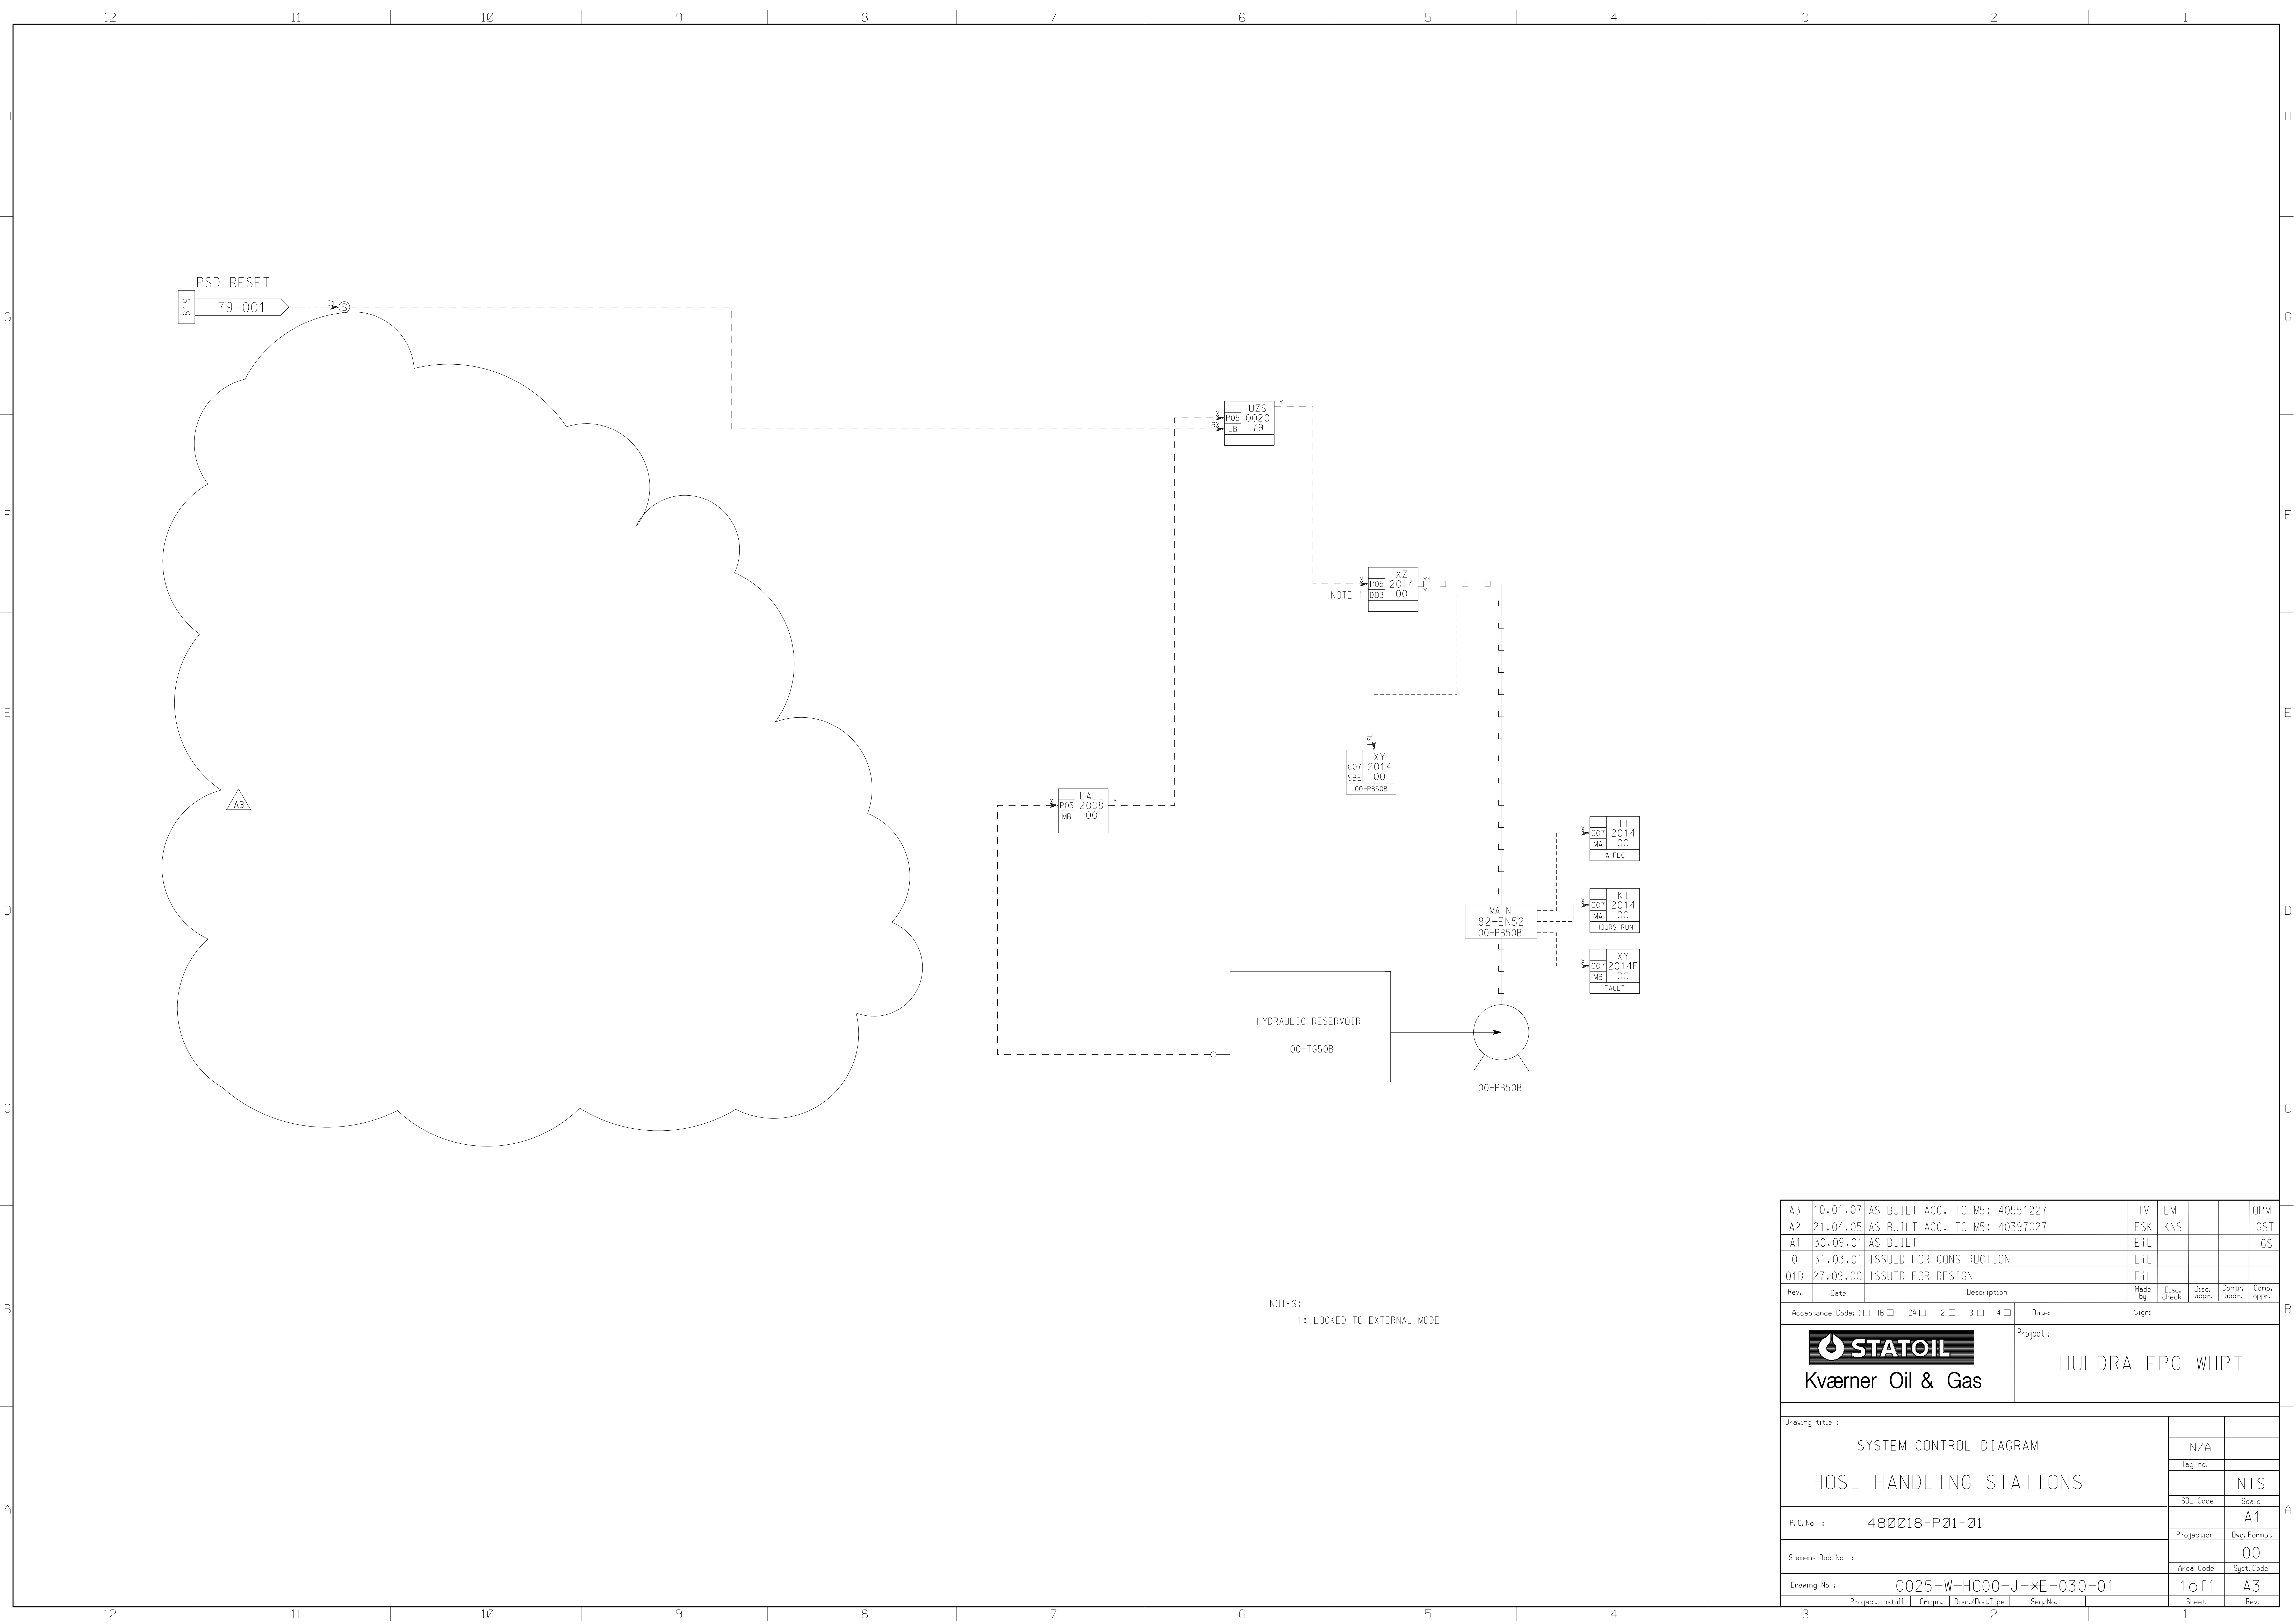

A3	10.01.07	AS BUILT ACC. TO M5: 40551227	TV	LM			OPM
A2	21.04.05	AS BUILT ACC. TO M5: 40397027	ESK	KNS			GST
A1	30.09.01	AS BUILT	EiL				GS
0	31.03.01	ISSUED FOR CONSTRUCTION	EiL				
01D	27.09.00	ISSUED FOR DESIGN	EiL				
Rev.	Date	Description	Made by	Disc. check	Disc. appr.	Contr. appr.	Comp. appr.
Acceptance Codes 1 ☐ IB ☐ 2A ☐ 2 ☐ 3 ☐ 4 ☐			Signs				
STATOIL Kværner Oil & Gas			Project : HULDRA EPC WHPT				
Drawing title :							
SYSTEM CONTROL DIAGRAM			N/A				
			Tag no.				
			NTS				
P.O.No : 480018-P01-01			A1				
Siemens Doc.No :			00				
Drawing No : C025-W-H000-J- E -030-01			1 of 1				
			A3				
			Rev.				