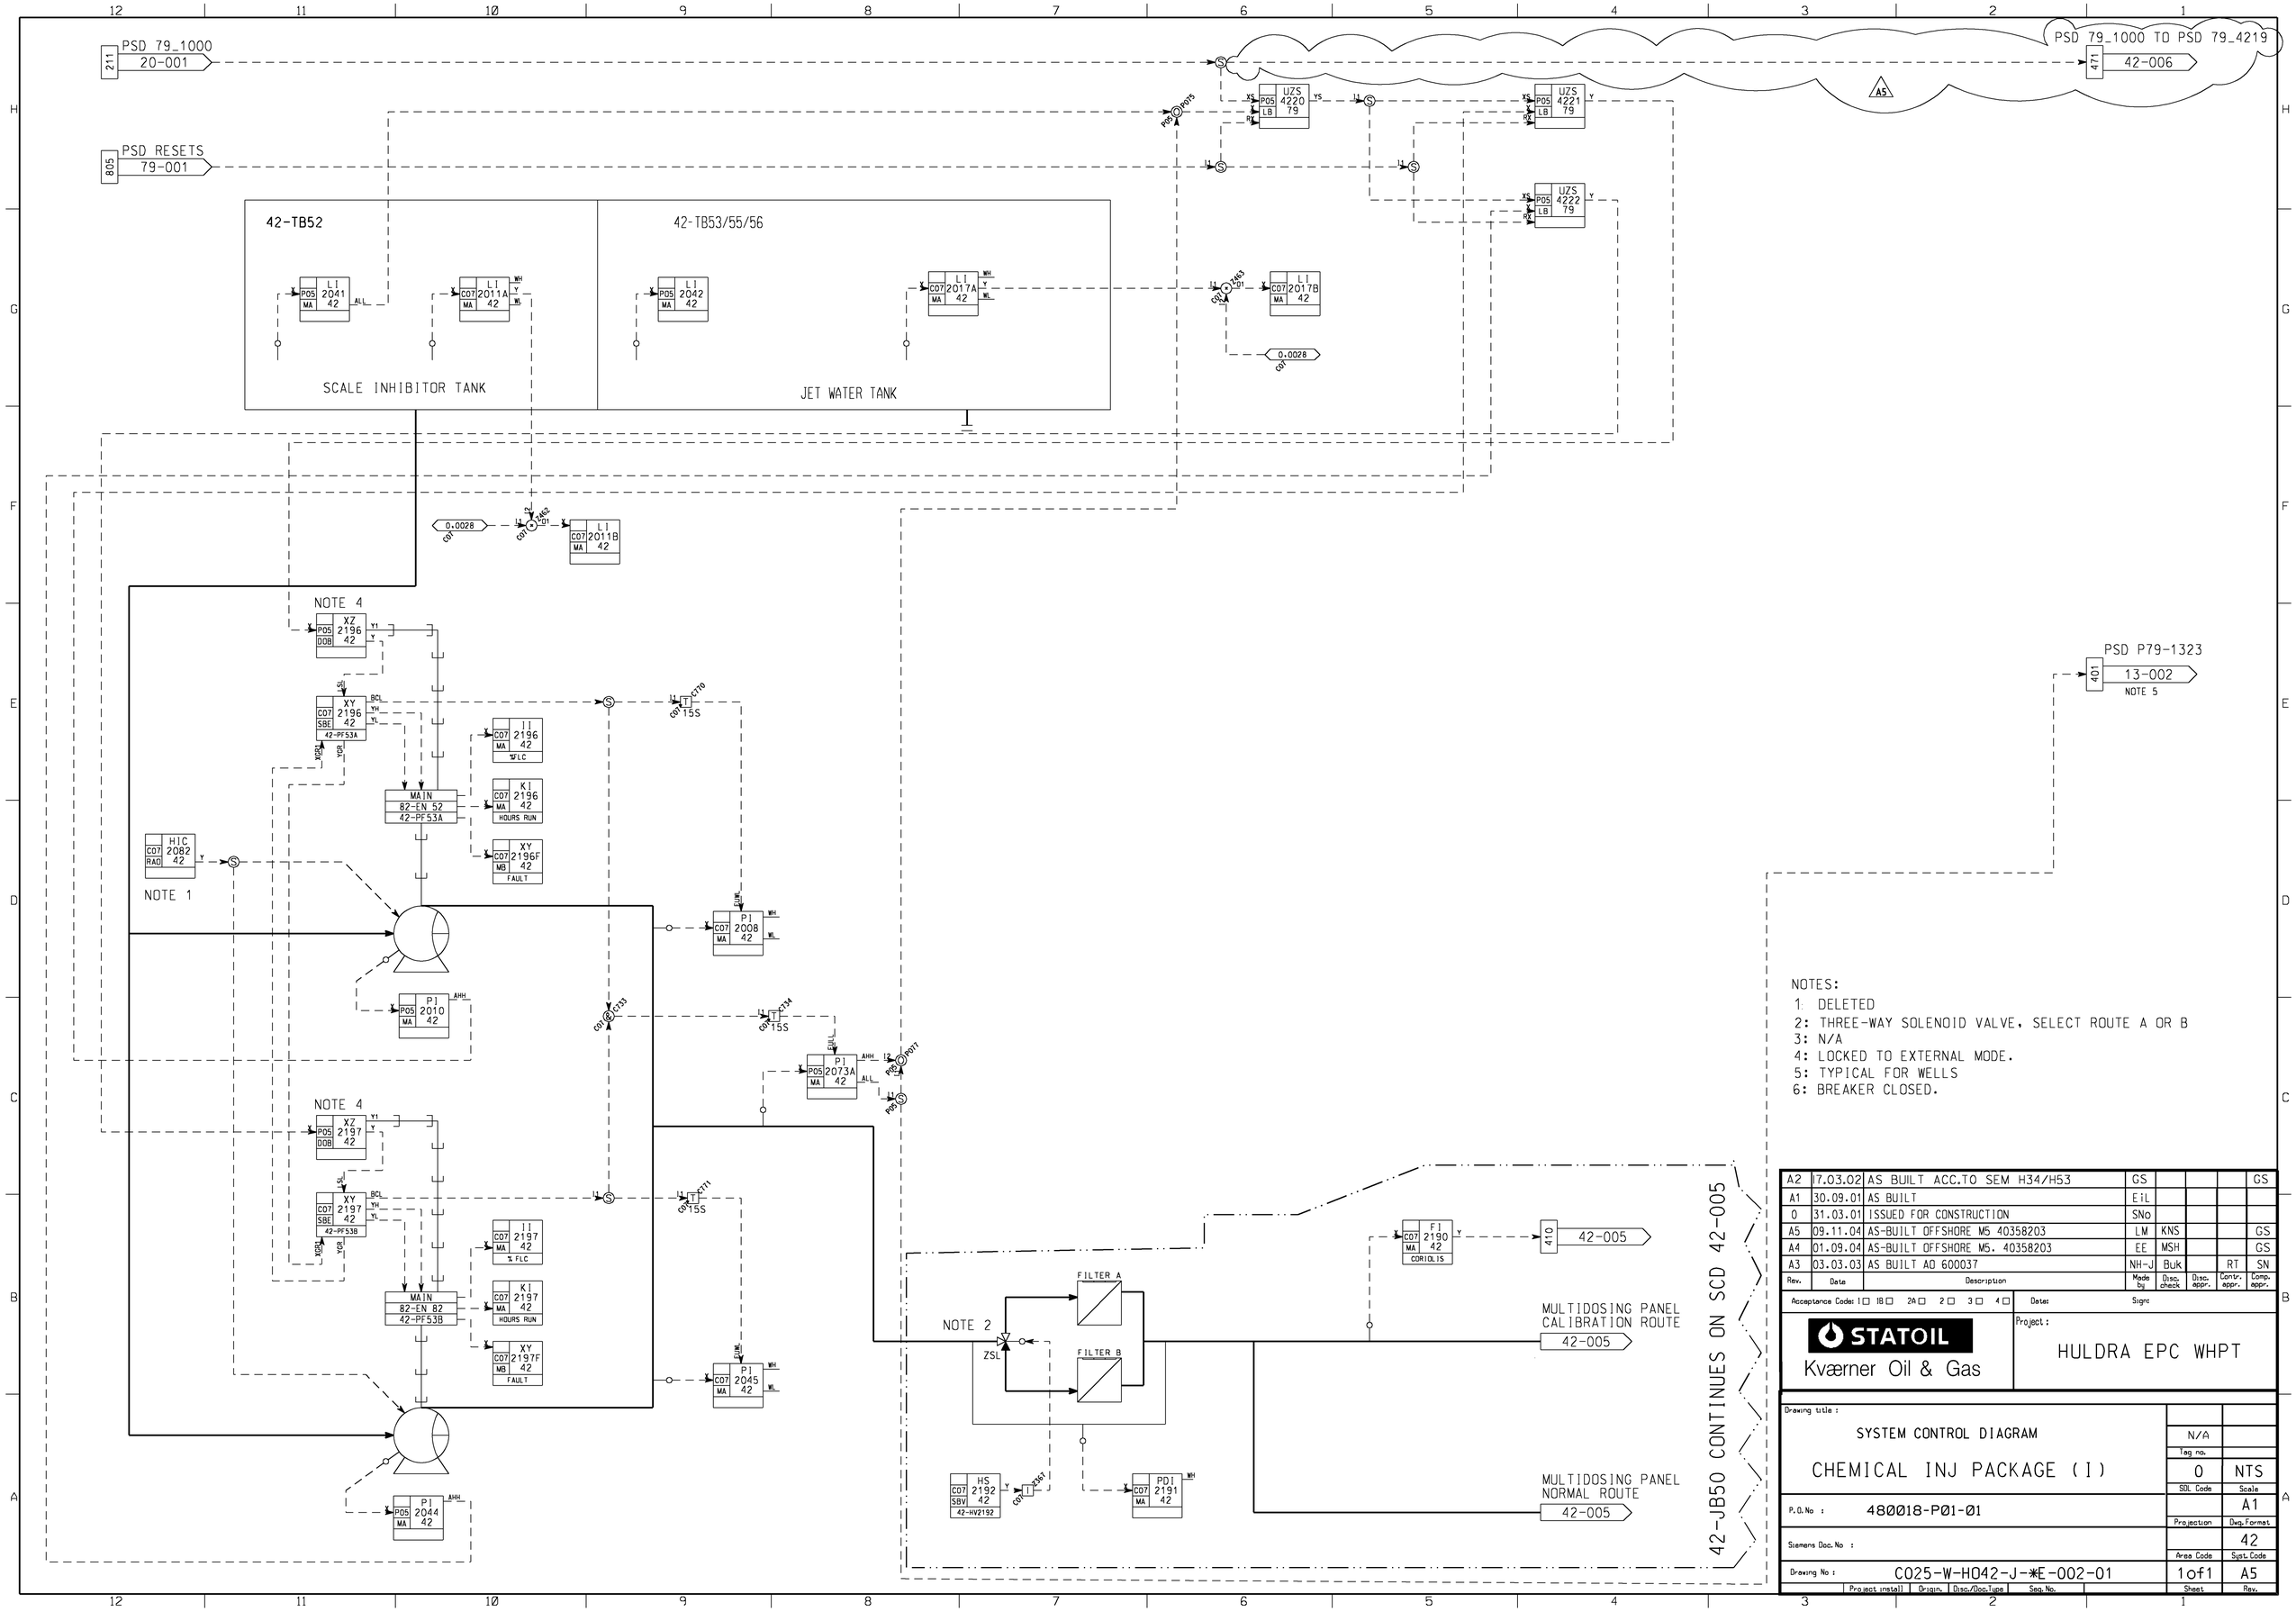

NOTES:
1: DELETED
2: THREE-WAY SOLENOID VALVE, SELECT ROUTE A OR B
3: N/A
4: LOCKED TO EXTERNAL MODE.
5: TYPICAL FOR WELLS
6: BREAKER CLOSED.

Rev.	Date	Description	Made by	Disc. check	Disc. appr.	Contr. appr.	Comp. appr.
A2	17.03.02	AS BUILT ACC.TO SEM H34/H53	GS				GS
A1	30.09.01	AS BUILT	EiL				
0	31.03.01	ISSUED FOR CONSTRUCTION	SNo				
A5	09.11.04	AS-BUILT OFFSHORE M5 40358203	LM	KNS			GS
A4	01.09.04	AS-BUILT OFFSHORE M5. 40358203	EE	MSH			GS
A3	03.03.03	AS BUILT AO 600037	NH-J	Buk		RT	SN

Acceptance Code: 1☐ 1B☐ 2A☐ 2☐ 3☐ 4☐ Date: Sign:

STATOIL
Kværner Oil & Gas

Project: HULDRA EPC WHPT

Drawing title: SYSTEM CONTROL DIAGRAM
CHEMICAL INJ PACKAGE (I)

P.O.No: 480018-P01-01

Siemens Doc.No:

Drawing No: C025-W-H042-J-*E-002-01

Tag no.	
N/A	
SDL Code	Scale
0	NTS
Projection	Dwg.Format
	A1
Area Code	Syst.Code
	42
Sheet	Rev.
1of1	A5